



Dart Aerospace Ltd.  
1270 Aberdeen St  
Hawkesbury, ON  
K6A 1K7  
Canada

Tel (613) 632-5200

**D5610-3**  
**Job Sheet 180819**

Accounting Job RD17-1048-01



Part No: D5610-3

Job Qty: 8 ea

Part Name: Cuff



Part Weight: 0 lbs

Status: Scheduled

Priority: Medium

Job Created: 7/17/18

Job Tracking No:

Due Date: 7/27/18

Created By: Marie Lajeunesse

Type: R+D

Description:

Note: DWG D5610-3 REV:A8 NEW ISSUE 18/06/20 JFS VERIFIED BY:DD

Ship Via:

**PRELIMINARY ISSUE**

**POSITIVE RECALL**

EFFECTIVE JUL 17 2018

RELEASED 9 DATE 18-10-01

### Bill of Materials

### Job Routing

| Op No | Operation          | Qty   | Start Date | Due Date | Standard  |         | Workcenter/Supplier   |           | Sign-off |
|-------|--------------------|-------|------------|----------|-----------|---------|-----------------------|-----------|----------|
|       |                    |       |            |          | Setup hrs | Run Hrs | Workcenter / Supplier | Lead Time |          |
| 90    | Start up Operation | 8 Ea  | 7/27/18    | 7/27/18  | 0.00      | 0.00    | Start Up Machining-2  |           |          |
| 100   | Bandsaw            | 8 pcs | 7/27/18    | 7/27/18  | 0.00      | 1.25    | Bandsaw1              |           |          |
| 110   | Doosan             | 8 pcs | 7/27/18    | 7/27/18  | 0.00      | 5.41    | Doosan                |           |          |
| 120   | QC                 | 8 pcs | 7/27/18    | 7/27/18  | 0.00      | 0.00    | QC2 Machining-2       |           |          |
| 130   | QC                 | 8 pcs | 7/27/18    | 7/27/18  | 0.00      | 0.00    | QC8 Machining-2       |           |          |
| 140   | HandFinish         | 8 pcs | 7/27/18    | 7/27/18  | 0.00      | 0.35    | HandFinish1           |           |          |
| 150   | QC                 | 8 pcs | 7/27/18    | 7/27/18  | 0.00      | 0.00    | QC3                   |           |          |
| 160   | Packaging          | 8 pcs | 7/27/18    | 7/27/18  | 0.00      | 0.00    | Packaging3-1          |           |          |
| 170   | QC21-SA            | 8 Ea  | 7/27/18    | 7/27/18  | 0.00      | 0.00    | QC21                  |           |          |

Part Op 100 - Cut blank 7.000 " long\*\*\*\*\* ATTN: PER BOM/ PER UNIT - DO NOT  
Descriptions: PULL THE "TOTAL ISSUE QTY"\*\*\*\*\*

110 - 1-Turn as per folio FC155 & DWG D5610. 2- Debur

### Job BOM

| Part / Item | Component Name | Quantity          | Operation             | Container |
|-------------|----------------|-------------------|-----------------------|-----------|
| D6030-140   | Tube, Seamless | .4000 Ea (.05 ea) | 90-Start up Operation |           |

### Job Allocations

| Operation             | Component Part | Required | Inventory | Allocated |
|-----------------------|----------------|----------|-----------|-----------|
| 90-Start up Operation | D6030-140      | 0        | 16        | 0         |

### Part Specifications

Specifications could not be found.

Plex 7/17/18 8:51 AM Dart.lajeunesse.marie

DQA: \_\_\_\_\_ Date: \_\_\_\_\_

# WORK ORDER NON-CONFORMANCE / UPDATE

QA Closed: \_\_\_\_\_ Date: \_\_\_\_\_ Work Order update only ☐

| |
|---|
| Work Order: _____<br><br>Part No. _____<br><br>NCR No. _____   |                                                | <b>DISPOSITION</b><br><br>Rework <input type="checkbox"/><br>Scrap <input type="checkbox"/><br>Use-as-is <input type="checkbox"/><br>Suspected Unapproved <input type="checkbox"/> |                                      | <b>AGAINST DEPARTMENT/PROCESS</b><br><br><table border="0"> <tr> <td>Skid-tube <input type="checkbox"/></td> <td>Cross tube <input type="checkbox"/></td> <td>Water Jet <input type="checkbox"/></td> <td>Engineering <input type="checkbox"/></td> </tr> <tr> <td>Machining <input type="checkbox"/></td> <td>Small Fab <input type="checkbox"/></td> <td>Prod. Eng. Coord. <input type="checkbox"/></td> <td>Quality <input type="checkbox"/></td> </tr> <tr> <td>Thermoforming <input type="checkbox"/></td> <td>Finishing <input type="checkbox"/></td> <td>Rec/Store/Packaging <input type="checkbox"/></td> <td>Other <input type="checkbox"/></td> </tr> <tr> <td>Large Fab <input type="checkbox"/></td> <td>Composite <input type="checkbox"/></td> <td>Supplier <input type="checkbox"/></td> <td></td> </tr> </table> |                                             |                                          |                                              |                                   |                                  | 
| Date :   |                                                | Step #:   |                                      | QTY Effective :   |                                             |                                          | MRB (QSI042) Approval                        | |
| Description Work Order Deviation   |                                                |   |                                      | Disposition   |                                             |                                          | Completed By                                 | |
|   |                                                |   |                                      |   |                                             |                                          | Lead hand / Supervisor Approval Verification | |
| |
|   |                                                |   |                                      |   |                                             |                                          | QC / QA Coordinator Approval                 | |
| <b>Root Cause</b><br><table border="0"> <tr> <td>Environment <input type="checkbox"/></td> <td>No Re-verification <input type="checkbox"/></td> <td>Pressure/Forced <input type="checkbox"/></td> </tr> <tr> <td>Design <input type="checkbox"/></td> <td>Operator <input type="checkbox"/></td> <td>Bending <input type="checkbox"/></td> </tr> <tr> <td>Doc/Data <input type="checkbox"/></td> <td>Offset/Setup <input type="checkbox"/></td> <td>Centre Not Concentric <input type="checkbox"/></td> </tr> <tr> <td>Equip/Tooling <input type="checkbox"/></td> <td>Supplier <input type="checkbox"/></td> <td>Cracks <input type="checkbox"/></td> </tr> <tr> <td>Handling/Pre <input type="checkbox"/></td> <td>Training <input type="checkbox"/></td> <td>Crimp/Kink/Ripple/Wave <input type="checkbox"/></td> </tr> <tr> <td>Material <input type="checkbox"/></td> <td>Use for Testing <input type="checkbox"/></td> <td>Cuffs <input type="checkbox"/></td> </tr> <tr> <td>Internal Transport <input type="checkbox"/></td> <td>Poor Information <input type="checkbox"/></td> <td>Crushing <input type="checkbox"/></td> </tr> <tr> <td>Tribal Knowledge <input type="checkbox"/></td> <td>Rushing <input type="checkbox"/></td> <td>Heat Treat <input type="checkbox"/></td> </tr> <tr> <td>LOA <input type="checkbox"/></td> <td>Product Improvement <input type="checkbox"/></td> <td>Wave/Twist in Tube <input type="checkbox"/></td> </tr> <tr> <td>Substation <input type="checkbox"/></td> <td>Process Improvement <input type="checkbox"/></td> <td>Marks/Chatter <input type="checkbox"/></td> </tr> <tr> <td>Past Expiry Date <input type="checkbox"/></td> <td>Manufacturing Process <input type="checkbox"/></td> <td></td> </tr> <tr> <td>Misidentified <input type="checkbox"/></td> <td>Past Due <input type="checkbox"/></td> <td>OTHER : _____</td> </tr>Manufacturing Process <input type="checkbox"/> |  | Misidentified <input type="checkbox"/> | Past Due <input type="checkbox"/> | OTHER : _____ | <b>FAULT CATEGORY</b><br><table border="0"> <tr> <td>Temperature/Cure <input type="checkbox"/></td> <td>Power Loss/Surge <input type="checkbox"/></td> <td>Positioned Wrong <input type="checkbox"/></td> </tr> <tr> <td>Set-up <input type="checkbox"/></td> <td>Folio/Program <input type="checkbox"/></td> <td>Outside Dimensions <input type="checkbox"/></td> </tr> <tr> <td>BOM/Route <input type="checkbox"/></td> <td>Grain <input type="checkbox"/></td> <td>Over/Under tolerance <input type="checkbox"/></td> </tr> <tr> <td>Broken/Damage/Defect <input type="checkbox"/></td> <td>Weld <input type="checkbox"/></td> <td>Part Incorrect <input type="checkbox"/></td> </tr> <tr> <td>Inspection Incomplete/Unqualified <input type="checkbox"/></td> <td>Wrong Stock Pulled <input type="checkbox"/></td> <td>Part Lost/Missing <input type="checkbox"/></td> </tr> <tr> <td>Contamination <input type="checkbox"/></td> <td>Out of Sequence <input type="checkbox"/></td> <td>Part Moved <input type="checkbox"/></td> </tr> <tr> <td>Countersink <input type="checkbox"/></td> <td>Off-set <input type="checkbox"/></td> <td>Drawing <input type="checkbox"/></td> </tr> <tr> <td>Cut Too Short <input type="checkbox"/></td> <td>Mislabeled <input type="checkbox"/></td> <td>Finish <input type="checkbox"/></td> </tr> <tr> <td>Instructions Incomplete/Unclear <input type="checkbox"/></td> <td>Fit/Function <input type="checkbox"/></td> <td>Misread <input type="checkbox"/></td> </tr> <tr> <td>Drill Holes <input type="checkbox"/></td> <td>Misaligned/off center <input type="checkbox"/></td> <td>Turning Sequence <input type="checkbox"/></td> </tr>





DQA: \_\_\_\_\_ Date: \_\_\_\_\_




## WORK ORDER NON-CONFORMANCE / UPDATE

QA Closed: \_\_\_\_\_ Date: \_\_\_\_\_


Work Order update only ☐

|   |   
|---|---|---|---|---|---|---|-----------------------|----------------------------------------------|--|------------------------------------|-------------------------------------|---|---|---|---|--------------------------------------------|----------------------------------|----------------------------------------|------------------------------------|----------------------------------------------|--------------------------------|------------------------------------|------------------------------------|-----------------------------------|--|
| Work Order: _____<br><br>Part No. _____<br><br>NCR No. _____   |   | <b>DISPOSITION</b><br><br>Rework <input type="checkbox"/><br>Scrap <input type="checkbox"/><br>Use-as-is <input type="checkbox"/><br>Suspected Unapproved <input type="checkbox"/>   |   | <b>AGAINST DEPARTMENT/PROCESS</b><br><br><table style="width:100%; border: none;"> <tr> <td style="width:12.5%;">Skid-tube <input type="checkbox"/></td> <td style="width:12.5%;">Cross tube <input type="checkbox"/></td> <td style="width:12.5%;">Water Jet <input type="checkbox"/></td> <td style="width:12.5%;">Engineering <input type="checkbox"/></td> </tr> <tr> <td>Machining <input type="checkbox"/></td> <td>Small Fab <input type="checkbox"/></td> <td>Prod. Eng. Coord. <input type="checkbox"/></td> <td>Quality <input type="checkbox"/></td> </tr> <tr> <td>Thermoforming <input type="checkbox"/></td> <td>Finishing <input type="checkbox"/></td> <td>Rec/Store/Packaging <input type="checkbox"/></td> <td>Other <input type="checkbox"/></td> </tr> <tr> <td>Large Fab <input type="checkbox"/></td> <td>Composite <input type="checkbox"/></td> <td>Supplier <input type="checkbox"/></td> <td></td> </tr> </table> |   |   |                       |                                              |  | Skid-tube <input type="checkbox"/> | Cross tube <input type="checkbox"/> | Water Jet <input type="checkbox"/>   | 




| Date : _____   |   | Step #: _____   |   | QTY Effective : _____   |   |   | MRB (QSI042) Approval |                                              |  |                                    |                                     |   |   |   |   |                                            |                                  |                                        |                                    |                                              |                                |                                    |                                    |                                   |  |
| Description Work Order Deviation   |   |   |   | Disposition   |   |   |                       | Completed By                                 |  |                                    |                                     |   |   |   |   |                                            |                                  |                                        |                                    |                                              |                                |                                    |                                    |                                   |  |
|   |   |   |   |   |   |   |                       | Lead hand / Supervisor Approval Verification |  |                                    |                                     |   |   |   |   |                                            |                                  |                                        |                                    |                                              |                                |                                    |                                    |                                   |  |
|   |   |   |   |   |   |   |                       | QC / QA Coordinator Approval                 |  |                                    |                                     |   |   |   |   |                                            |                                  |                                        |                                    |                                              |                                |                                    |                                    |                                   |  |
|   |   
| Root Cause   |   |   |   | FAULT CATEGORY   |   |   
| <table style="width:100%; border: none;"> <tr> <td style="width:50%;">           Environment <input type="checkbox"/><br/>           Design <input type="checkbox"/><br/>           Doc/Data <input type="checkbox"/><br/>           Equip/Tooling <input type="checkbox"/><br/>           Handling/Pre <input type="checkbox"/><br/>           Material <input type="checkbox"/><br/>           Internal Transport <input type="checkbox"/><br/>           Tribal Knowledge <input type="checkbox"/><br/>           LOA <input type="checkbox"/><br/>           Substation <input type="checkbox"/><br/>           Past Expiry Date <input type="checkbox"/><br/>           Misidentified <input type="checkbox"/> </td> <td style="width:50%;">           No Re-verification <input type="checkbox"/><br/>           Operator <input type="checkbox"/><br/>           Offset/Setup <input type="checkbox"/><br/>           Supplier <input type="checkbox"/><br/>           Training <input type="checkbox"/><br/>           Use for Testing <input type="checkbox"/><br/>           Poor Information <input type="checkbox"/><br/>           Rushing <input type="checkbox"/><br/>           Product Improvement <input type="checkbox"/><br/>           Process Improvement <input type="checkbox"/><br/>           Manufacturing Process <input type="checkbox"/><br/>           Past Due <input type="checkbox"/> </td> </tr><table style="width:100%; border: none;"> <tr> <td style="width:33%;">           Pressure/Forced <input type="checkbox"/><br/>           Bending <input type="checkbox"/><br/>           Centre Not Concentric <input type="checkbox"/><br/>           Cracks <input type="checkbox"/><br/>           Crimp/Kink/Ripple/Wave <input type="checkbox"/><br/>           Cuffs <input type="checkbox"/><br/>           Crushing <input type="checkbox"/><br/>           Heat Treat <input type="checkbox"/><br/>           Wave/Twist in Tube <input type="checkbox"/><br/>           Marks/Chatter <input type="checkbox"/> </td> <td style="width:33%;">           Temperature/Cure <input type="checkbox"/><br/>           Set-up <input type="checkbox"/><br/>           BOM/Route <input type="checkbox"/><br/>           Broken/Damage/Defect <input type="checkbox"/><br/>           Inspection Incomplete/Unqualified <input type="checkbox"/><br/>           Contamination <input type="checkbox"/><br/>           Countersink <input type="checkbox"/><br/>           Cut Too Short <input type="checkbox"/><br/>           Instructions Incomplete/Unclear <input type="checkbox"/><br/>           Drill Holes <input type="checkbox"/> </td> <td style="width:33%;">           Power Loss/Surge <input type="checkbox"/><br/>           Folio/Program <input type="checkbox"/><br/>           Grain <input type="checkbox"/><br/>           Weld <input type="checkbox"/><br/>           Wrong Stock Pulled <input type="checkbox"/><br/>           Out of Sequence <input type="checkbox"/><br/>           Off-set <input type="checkbox"/><br/>           Misabeled <input type="checkbox"/><br/>           Fit/Function <input type="checkbox"/><br/>           Misaligned/off center <input type="checkbox"/> </td> <td style="width:33%;">           Positioned Wrong <input type="checkbox"/><br/>           Outside Dimensions <input type="checkbox"/><br/>           Over/Under tolerance <input type="checkbox"/><br/>           Part Incorrect <input type="checkbox"/><br/>           Part Lost/Missing <input type="checkbox"/><br/>           Part Moved <input type="checkbox"/><br/>           Drawing <input type="checkbox"/><br/>           Finish <input type="checkbox"/><br/>           Misread <input type="checkbox"/><br/>           Turning Sequence <input type="checkbox"/> </td> </tr> </table> |                       |                                              |  |                                    |                                     | Pressure/Forced <input type="checkbox"/><br>Bending <input type="checkbox"/><br>Centre Not Concentric <input type="checkbox"/><br>Cracks <input type="checkbox"/><br>Crimp/Kink/Ripple/Wave <input type="checkbox"/><br>Cuffs <input 


| OTHER : _____   |   |   





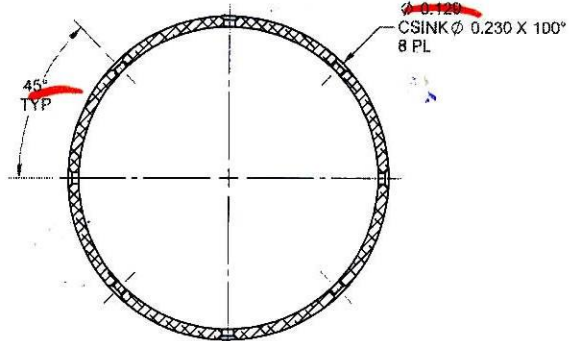

**SECTION A-A**  
2 PL

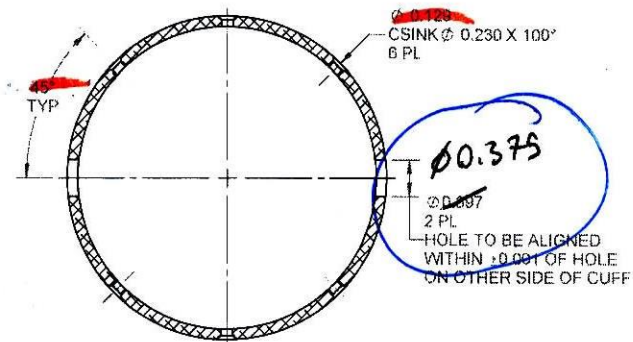

**SECTION B-B**

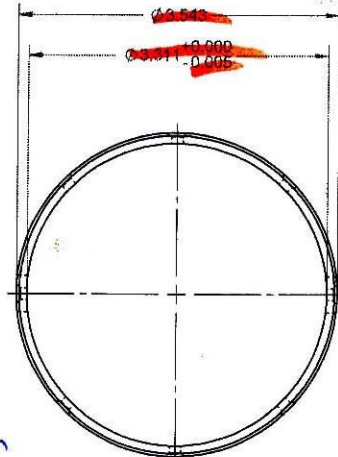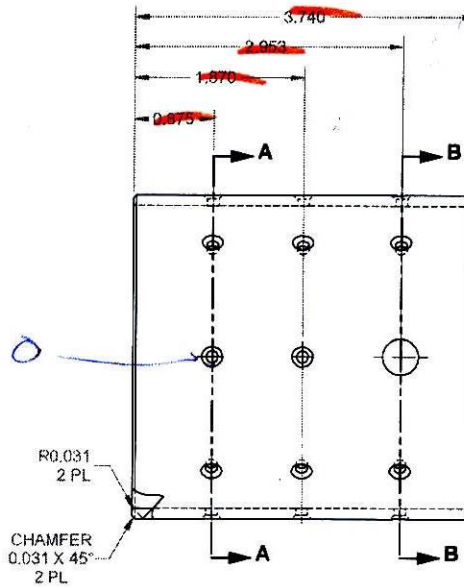

**D5610-3 CUFF**

SHOP COPY  
RETURN TO  
ENGINEERING  
UNCONTROLLED COPY  
SUBJECT TO AMENDMENT  
WITHOUT NOTICE  
WORK ORDER  
NO. 180819 M05  
180717

- NOTES:**
  - 2) FINISH: CHEMICAL CONVERSION COAT PER DART QSI 005 4.1
  - 3) TOLERANCES: PER DART QSI 018 UNLESS OTHERWISE NOTED
  - 4) UNITS: INCHES UNLESS OTHERWISE NOTED
  - 5) BREAK SHARP EDGES: 0.005 TO 0.010 MAX
  - 6) IDENTIFICATION: NONE
  - 7) WEIGHT: 0.46 lbs

PRELIMINARY ISSUE

|            |          |   |              |
|------------|----------|---|--------------|
| DESIGN     | NO       | <b>DART AEROSPACE LTD</b>   |              |
| DRAWN      | ZF       | HAWKESBURY, ONTARIO, CANADA   |              |
| CHECKED    | NO       | DRAWING NO.   | REV. A8      |
| MFG. APPR. | DP       | D5610   | SHEET 3 OF 3 |
| APPROVED   |          | TITLE   | SCALE        |
| DE APPR.   |          | EC130 AFT X-TUBE   | NTS          |
| DATE       | 18.05.07 | <small>COPYRIGHT © 2018 BY DART AEROSPACE LTD<br/>THIS DOCUMENT IS PRIVATE AND CONFIDENTIAL AND IS SUPPLIED ON THE EXPRESS CONDITION THAT IT IS NOT TO BE USED FOR ANY PURPOSE OR COPIED OR COMMUNICATED TO ANY OTHER PERSON WITHOUT WRITTEN PERMISSION FROM DART AEROSPACE LTD.</small> |              |

DQA: \_\_\_\_\_ Date: 18/08/10

## WORK ORDER NON-CONFORMANCE / UPDATE

QA Closed: \_\_\_\_\_ Date: \_\_\_\_\_

Work Order update only ☐

|                            |   |                                        |                                                |                                              |                                      |
|----------------------------|---|----------------------------------------|------------------------------------------------|----------------------------------------------|--------------------------------------|
| Work Order: <u>1808 19</u> | <b>DISPOSITION</b><br>Rework <input type="checkbox"/><br>Scrap <input type="checkbox"/><br>Use-as-is <input checked="" type="checkbox"/><br>Suspected Unapproved <input type="checkbox"/> | <b>AGAINST DEPARTMENT/PROCESS</b>      |                                                |                                              |                                      |
| Part No. <u>D5610-3</u>    |   | Skid-tube <input type="checkbox"/>     | Cross tube <input checked="" type="checkbox"/> | Water Jet <input type="checkbox"/>           | Engineering <input type="checkbox"/> |
| NCR No.                    |   | Machining <input type="checkbox"/>     | Small Fab <input type="checkbox"/>             | Prod. Eng. Coord. <input type="checkbox"/>   | Quality <input type="checkbox"/>     |
|                            |   | Thermoforming <input type="checkbox"/> | Finishing <input type="checkbox"/>             | Rec/Store/Packaging <input type="checkbox"/> | Other <input type="checkbox"/>       |
|                            |   | Large Fab <input type="checkbox"/>     | Composite <input type="checkbox"/>             | Supplier <input type="checkbox"/>            |                                      |

Date : \_\_\_\_\_ Step #: \_\_\_\_\_ QTY Effective : \_\_\_\_\_ MRB (QS1042) Approval

14SP  
12 9 18/8/10

Description Work Order Deviation Disposition

It is acceptable to use  $\phi 0.375$  hole instead of  $\phi 0.396$  hole as marked up on drawing.

Acceptable

Completed By

Lead hand / Supervisor Approval Verification

PD 18-08-04

| Root Cause                                        |                                                |                                                 |  |
|---------------------------------------------------|------------------------------------------------|-------------------------------------------------|--|
| Environment <input type="checkbox"/>              | No Re-verification <input type="checkbox"/>    | Pressure/Forced <input type="checkbox"/>        |  |
| Design <input type="checkbox"/>                   | Operator <input type="checkbox"/>              | Bending <input type="checkbox"/>                |  |
| Doc/Data <input type="checkbox"/>                 | Offset/Setup <input type="checkbox"/>          | Centre Not Concentric <input type="checkbox"/>  |  |
| Equip/Tooling <input checked="" type="checkbox"/> | Supplier <input type="checkbox"/>              | Cracks <input type="checkbox"/>                 |  |
| Handling/Pre <input type="checkbox"/>             | Training <input type="checkbox"/>              | Crimp/Kink/Ripple/Wave <input type="checkbox"/> |  |
| Material <input type="checkbox"/>                 | Use for Testing <input type="checkbox"/>       | Cuffs <input type="checkbox"/>                  |  |
| Internal Transport <input type="checkbox"/>       | Poor Information <input type="checkbox"/>      | Crushing <input type="checkbox"/>               |  |
| Tribal Knowledge <input type="checkbox"/>         | Rushing <input type="checkbox"/>               | Heat Treat <input type="checkbox"/>             |  |
| LOA <input type="checkbox"/>                      | Product Improvement <input type="checkbox"/>   | Wave/Twist in Tube <input type="checkbox"/>     |  |
| Substation <input type="checkbox"/>               | Process Improvement <input type="checkbox"/>   | Marks/Chatter <input type="checkbox"/>          |  |
| Past Expiry Date <input type="checkbox"/>         | Manufacturing Process <input type="checkbox"/> |                                                 |  |
| Misidentified <input type="checkbox"/>            | Past Due <input type="checkbox"/>              | OTHER : <input type="checkbox"/>                |  |

Dart Aerospace Ltd.  
1270 Aberdeen Street  
Hawkebury, ON K6A 1K7  
CANADA  
TEL.: 1 613 832-5200  
Email: sales@dartaero.com  
www.dartaero.com


Container No: S104655



Part: D5610-3

Job No: 180819

Serial No/Batch: S104655



Revision: A8

Inspector:

Exp Date:

Instructions: Various STC's

Date: 08/23/18

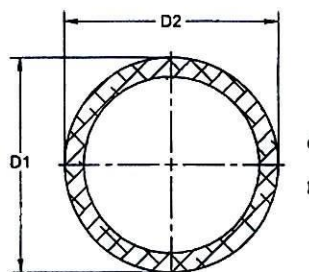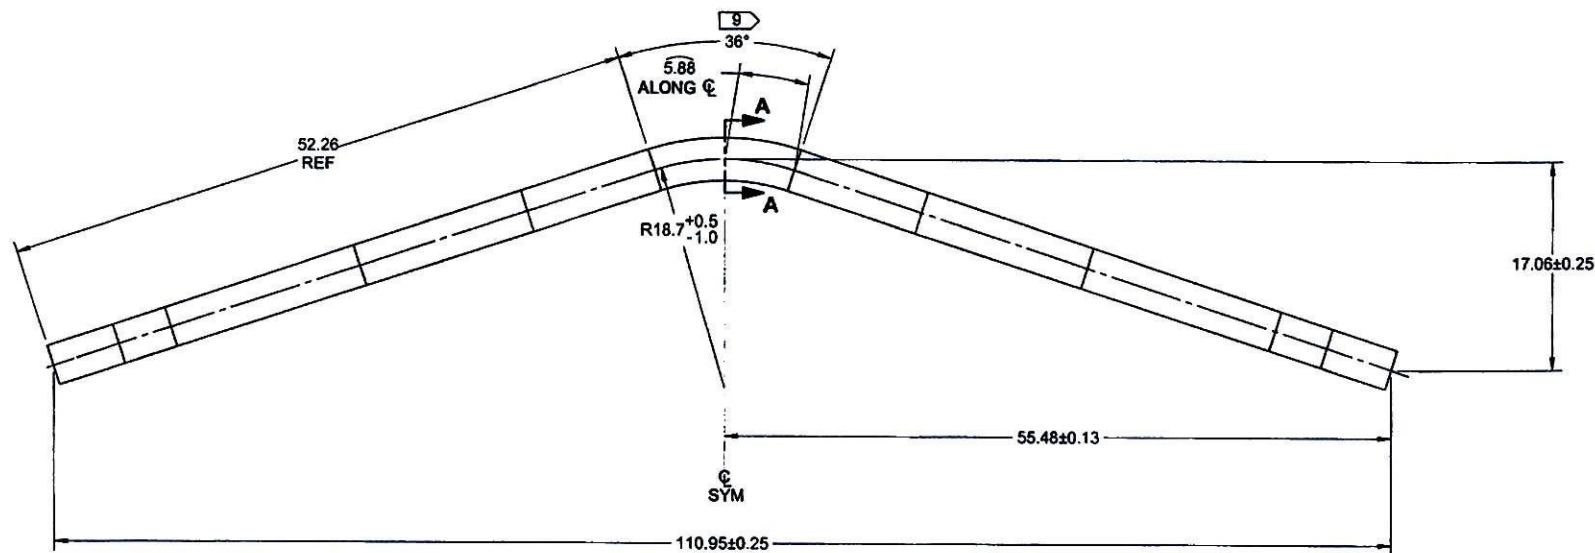

**SECTION A-A**  
SCALE 5X  
BEND CRUSHING MEASUREMENT

$$\text{CRUSHING} = \frac{(D2 - D1)}{(D2 + D1)}$$

MAXIMUM CRUSHING = 0.005

**D5610-1 AFT X-TUBE (EC130)**

RELEASED

2018 OCT 02  
ECN 14-517


**NOTES:**

- 1) MATERIAL: MAKE FROM D5610-1TRN
- 2) FINISH: NONE
- 3) TOLERANCES: PER DART QSI 018 UNLESS OTHERWISE NOTED
- 4) UNITS: INCHES UNLESS OTHERWISE NOTED
- 5) BREAK SHARP EDGES: N/A
- 6) IDENTIFICATION: NONE
- 7) WEIGHT: 31.6 lbs
- 8) EXTREME CARE MUST BE TAKEN TO PROTECT THE OUTSIDE SURFACE OF THE TUBE. THE OUTSIDE SURFACE MUST BE SMOOTH AND FREE FROM SURFACE DEFECTS SUCH AS SCRATCHES, NICKS, WRINKLES, OR DENTS. DEFECTS UP TO 0.005 MAY BE BLENDED OUT LONGITUDINALLY. CIRCUMFERENTIAL GRIND MARKS ARE UNACCEPTABLE
- 9) MAX AMPLITUDE OF RIPPLING ALONG BENT PORTION OF THE TUBE IS 0.030


APPROVED

|            |          |   |                    |              |          |
|------------|----------|---|--------------------|--------------|----------|
| A          |          | NEW ISSUE   |                    | ZF           | 18.05.07 |
| REV.       |          | DESCRIPTION   |                    | BY           | DATE     |
| DESIGN     | NO       | DART AEROSPACE LTD   |                    |              |          |
| DRAWN      | ZF       | HAWKESBURY, ONTARIO, CANADA   |                    |              |          |
| CHECKED    | MW       | DRAWING NO.   | D5610              | REV. A       |          |
| MFG. APPR. | JFS      | TITLE   | AFT X-TUBE (EC130) | SHEET 1 OF 3 |          |
| APPROVED   | NO       |   |                    | SCALE        |          |
| DE APPR.   | CP       |   |                    | NTS          |          |
| DATE       | 18.05.07 | <small>COPYRIGHT © 2018 BY DART AEROSPACE LTD<br/>THIS DOCUMENT IS PROPRIETARY AND CONFIDENTIAL AND IS SUPPLIED ON THE EXPRESS CONDITION THAT IT IS NOT TO BE USED FOR ANY PURPOSES OR COPIED OR COMMUNICATED TO ANY OTHER PERSON WITHOUT WRITTEN PERMISSION FROM DART AEROSPACE LTD.</small> |                    |              |          |




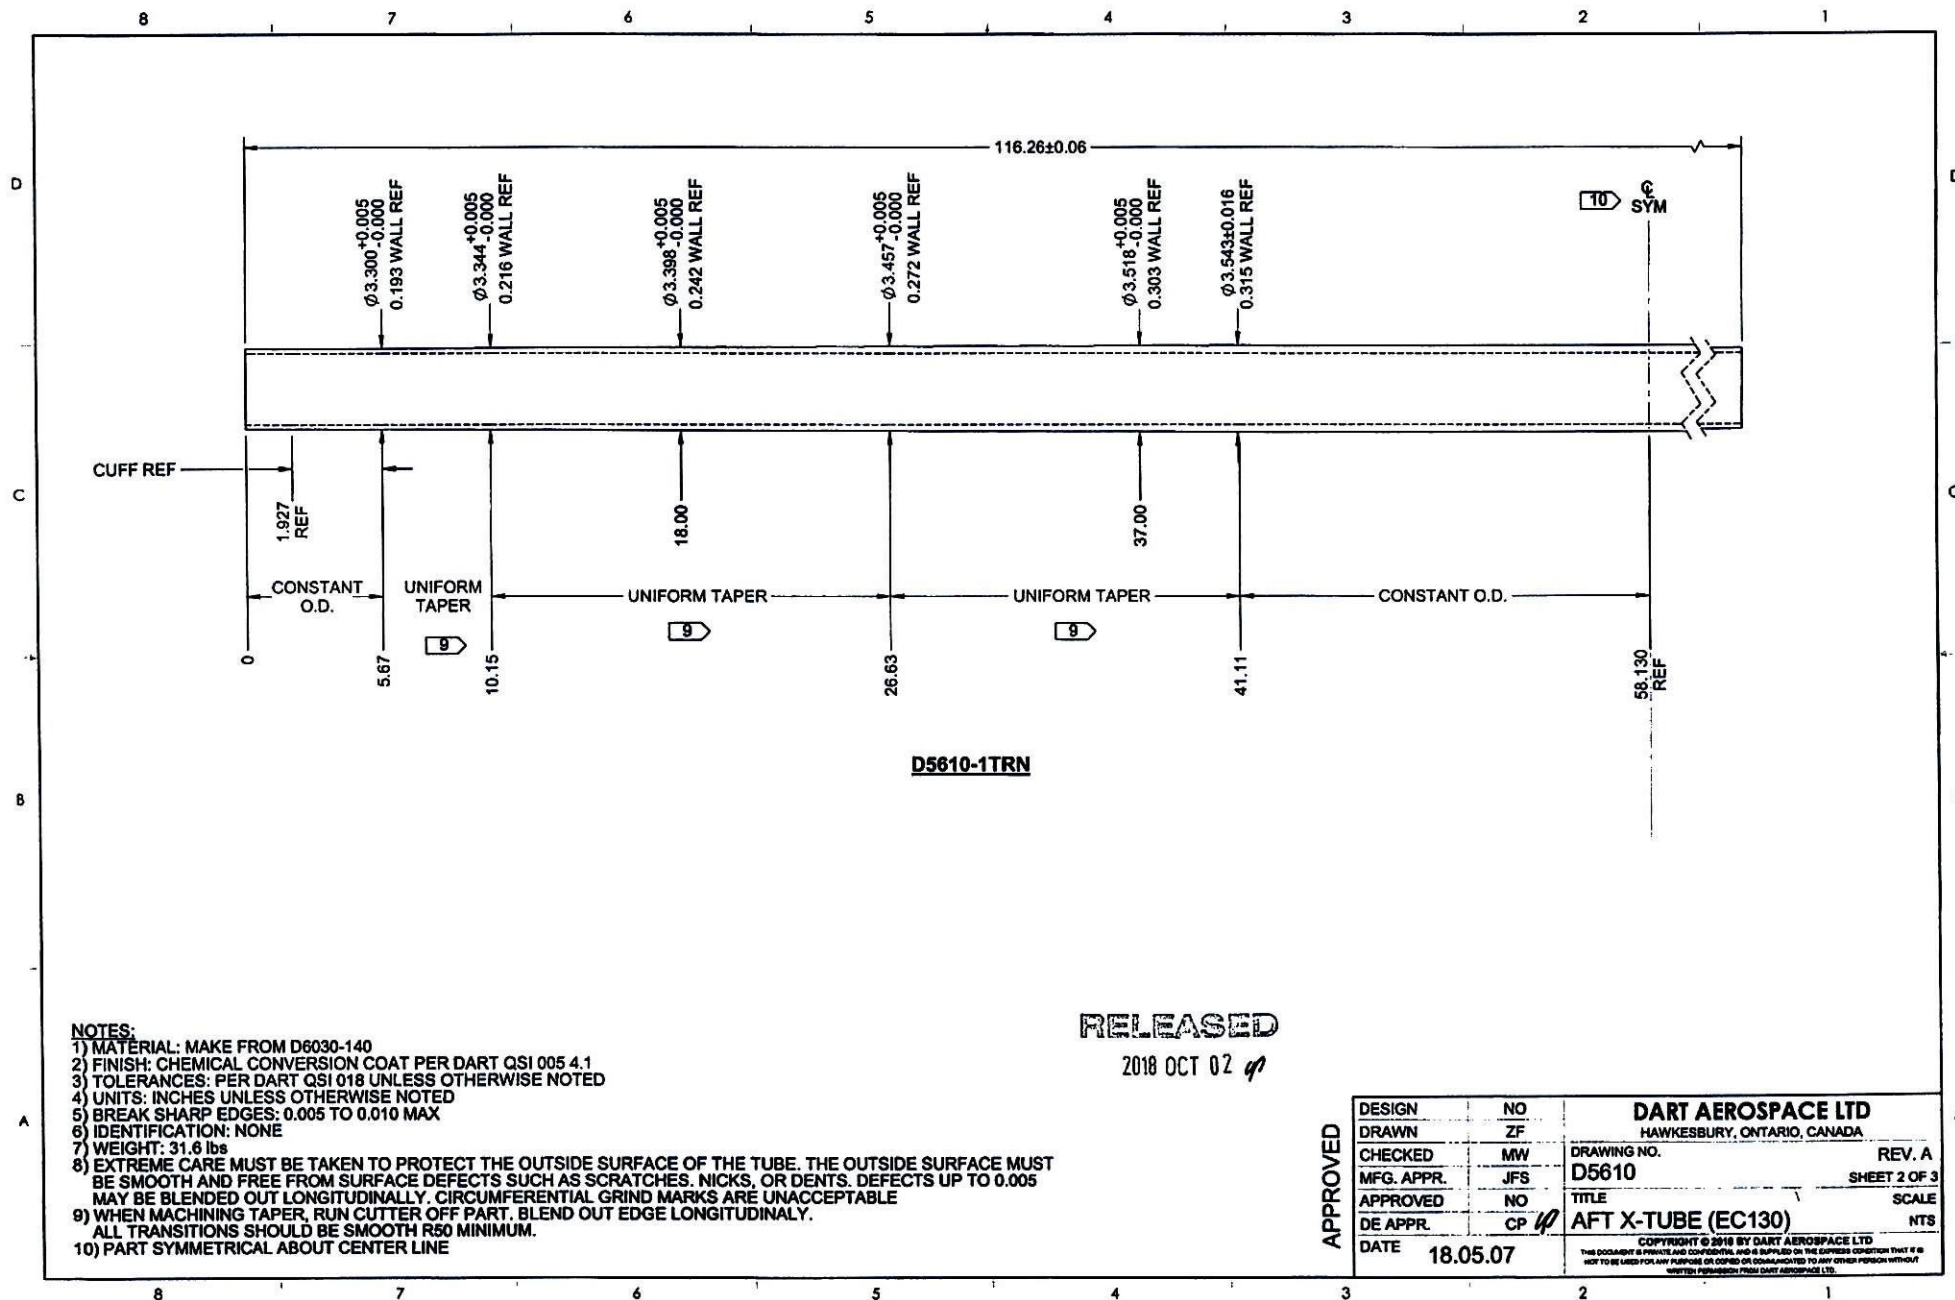




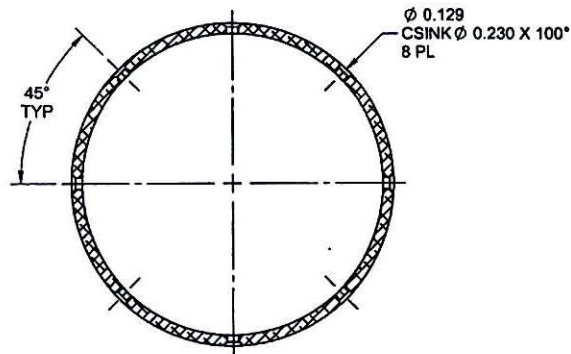


**SECTION B-B**

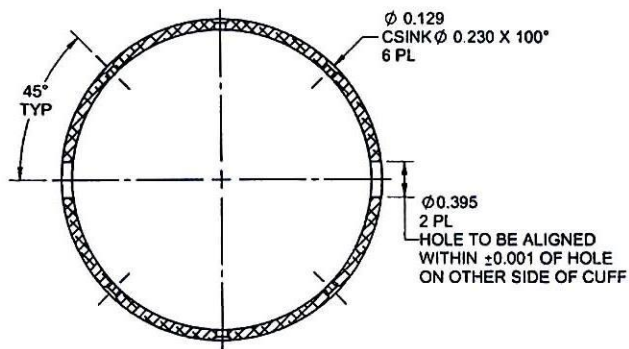

**SECTION C-C**

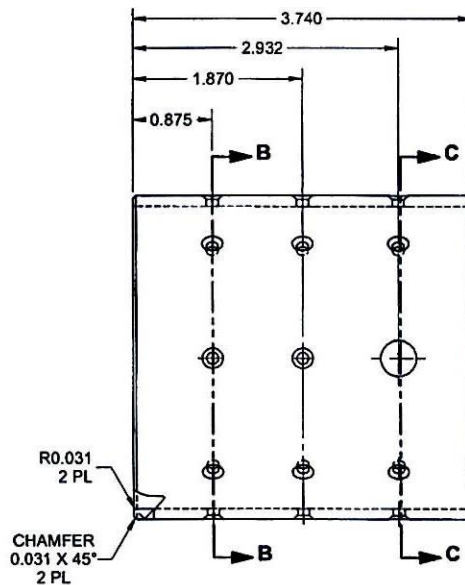

**D5610-3 CUFF**

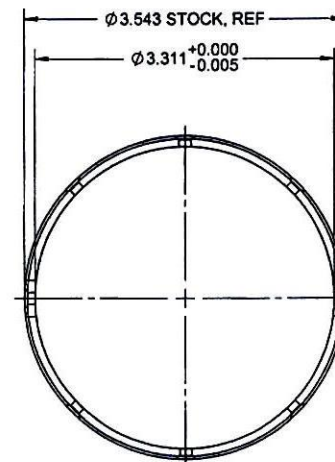

- NOTES:**
- 1) MATERIAL: MAKE FROM D6030-140
  - 2) FINISH: CHEMICAL CONVERSION COAT PER DART QSI 005 4.1
  - 3) TOLERANCES: PER DART QSI 018 UNLESS OTHERWISE NOTED
  - 4) UNITS: INCHES UNLESS OTHERWISE NOTED
  - 5) BREAK SHARP EDGES: 0.005 TO 0.010 MAX
  - 6) IDENTIFICATION: NONE
  - 7) WEIGHT: 0.46 lbs

**RELEASED**  
2018 OCT 02

**APPROVED**

|            |          |
|------------|----------|
| DESIGN     | NO       |
| DRAWN      | ZF       |
| CHECKED    | MW       |
| MFG. APPR. | JFS      |
| APPROVED   | NO       |
| DE APPR.   | CP       |
| DATE       | 18.05.07 |

|   |              |
|---|--------------|
| <b>DART AEROSPACE LTD</b><br>HAWKESBURY, ONTARIO, CANADA   |              |
| DRAWING NO.<br><b>D5610</b>   | REV. A       |
| TITLE<br><b>AFT X-TUBE (EC130)</b>   | SHEET 3 OF 3 |
| SCALE<br>NTS   |              |
| COPYRIGHT © 2018 BY DART AEROSPACE LTD<br>THIS DOCUMENT IS PRIVATE AND CONFIDENTIAL AND IS SUPPLIED ON THE EXPRESS UNDERSTANDING THAT IT IS NOT TO BE USED FOR ANY PURPOSE OR COPIED OR COMMUNICATED TO ANY OTHER PERSON WITHOUT WRITTEN PERMISSION FROM DART AEROSPACE LTD. |              |

Entered: \_\_\_\_\_ Date: \_\_\_\_\_



## WORK ORDER NON-CONFORMANCE / ROUTE UPDATE

NCR No. \_\_\_\_\_

Route update only ☐

|   |   |   |  |   |  |                                                               |  |   |   |   |
|---|---|---|--|---|--|---------------------------------------------------------------|--|---|---|---|
| Job: <u>180819</u><br>Part No. <u>D5610-3</u>   |   | <b>DISPOSITION</b><br>Rework <input type="checkbox"/><br>Scrap <input type="checkbox"/><br>Use-as-is <input checked="" type="checkbox"/>   |  | <b>DEPARTMENT/PROCESS</b><br><div style="display: flex; justify-content: space-between;"> <div>           Skid-tube <input type="checkbox"/><br/>           Machining <input type="checkbox"/><br/>           Large Fab <input type="checkbox"/> </div> <div>           Cross tube <input type="checkbox"/><br/>           Small Fab <input type="checkbox"/><br/>           Finishing <input type="checkbox"/> </div> <div>           Eng. (Non-AW) <input type="checkbox"/><br/>           Prod. Eng. Coord. <input type="checkbox"/><br/>           Rec/Store/Packaging <input type="checkbox"/> </div> <div>           Engineering <input checked="" type="checkbox"/><br/>           Water Jet <input type="checkbox"/><br/>           Supplier <input type="checkbox"/><br/>           Quality <input type="checkbox"/> </div> </div> |  |                                                               |  |   |   |   |
| Date : _____   |   | Sequence # : _____   |  | QTY Affected : _____   |  | <b>MRB (QSI042)</b><br><b>DAS</b><br><b>12</b><br><b>9-89</b> |  |   |   |   |
| <b>Description Work Order Deviation</b>   |   |   |  | <b>Disposition</b>   |  |                                                               |  |   |   |   |
| D5610-3 cuff hole drilled to $\phi 0.375$ ,<br>dwg calls for $\phi 0.395$ . Hole will<br>be reamed during installation on to<br>cross tube (D130-1048-241).   |   |   |  | Use as is. No effect on<br><del>D5610-3</del> final part.   |  |                                                               |  |   |   |   |
|   |   |   |  | <b>Completed By</b><br><b>DAS</b><br><b>12</b><br><b>9-89</b>   |  |                                                               |  |   |   |   |
|   |   |   |  | Lead hand / Supervisor   |  |                                                               |  |   |   |   |
|   |   |   |  | QC / QA Coordinator   |  |                                                               |  |   |   |   |
| <b>Root Cause</b><br>Operator <input type="checkbox"/><br>Manufacturing Process <input type="checkbox"/><br>Equip/Tooling <input type="checkbox"/><br>Handling/Preservation <input type="checkbox"/><br>Material <input type="checkbox"/><br>Product Improvement <input type="checkbox"/><br>Process Improvement <input type="checkbox"/><br>Human Factors <input type="checkbox"/> |   | <b>FAULT CATEGORY</b> <table style="width:100%; border: none;"> <tr> <td style="width:33%; vertical-align: top;"> <input type="checkbox"/> Pressure/Forced<br/> <input type="checkbox"/> Bending<br/> <input type="checkbox"/> Crushing<br/> <input type="checkbox"/> Cracks<br/> <input type="checkbox"/> Crimp/Kink/Ripple/Wave/Twist<br/> <input type="checkbox"/> Marks/Chatter<br/> <input type="checkbox"/> Mislabeled         </td> <td style="width:33%; vertical-align: top;"> <input type="checkbox"/> Contamination<br/> <input type="checkbox"/> Misaligned/off center<br/> <input type="checkbox"/> BOM/Route<br/> <input type="checkbox"/> Broken/Damage/Defect<br/> <input type="checkbox"/> Incomplete/Unclear Instructions<br/> <input type="checkbox"/> Drill Holes<br/> <input type="checkbox"/> Fit/Function         </td> <td style="width:33%; vertical-align: top;"> <input type="checkbox"/> Power Loss/Surge<br/> <input type="checkbox"/> Folio/Program<br/> <input type="checkbox"/> Grain Direction<br/> <input type="checkbox"/> Weld<br/> <input type="checkbox"/> Wrong Stock Pulled<br/> <input type="checkbox"/> Out of Sequence<br/> <input type="checkbox"/> Off-set/Set-up         </td> </tr>

|   |   | Other/Details:   |  |   |  |                                                               |  |   |   |   |